



SECTION - A A
(FROM SHT- 1 OF 2)



DETAIL - A1

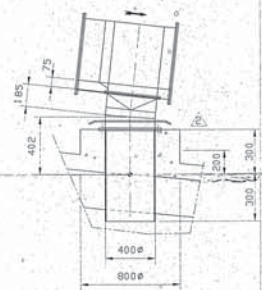


DETAIL - A2

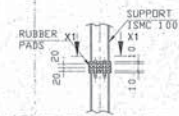


TYP. ANTI VIBRATION
PAD FIXING DET.
(FOR ALL SILD TOP AIRSLIDES)




X1-X1

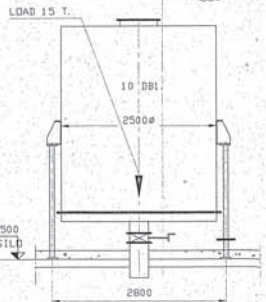

SECTION - B2 B2

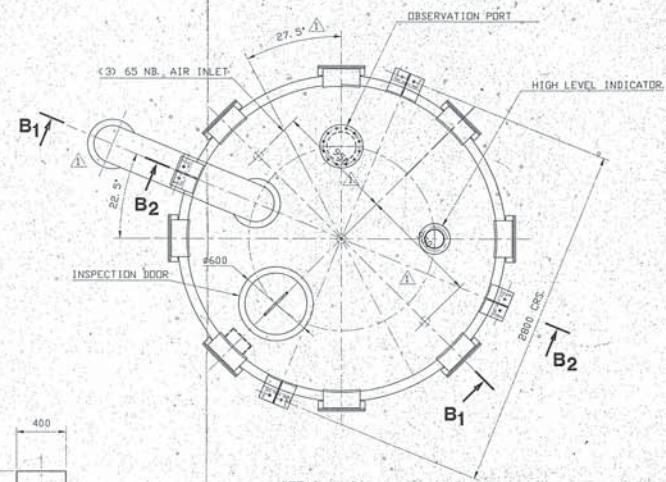


DETAIL - B
(FROM SHT- 1 OF 2)

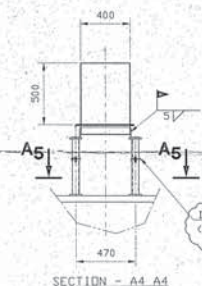

SECTION - A4 A4




ISOLATION PADS
(TYP. FOR ALL AIRSLIDES)

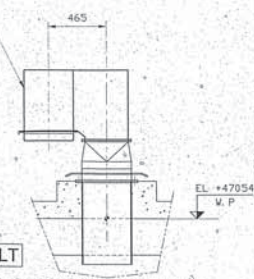

AS BUILT

SECTION - A3 A3

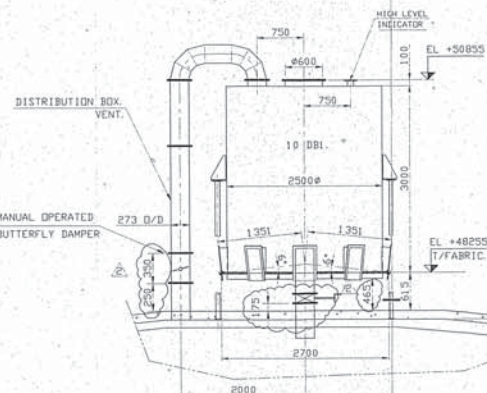

SECTION - B1 B1

